

**OWNERSHIP AND DEDICATION**

THE UNDERSIGNED HEREBY ACKNOWLEDGE(S) THIS PLAT AND ALLOTMENT TO BE IT'S FREE ACT AND DEED AND HEREBY DEDICATE(S) TO PUBLIC USE AS STREETS, PLAYGROUNDS, PARKS, OPEN SPACES, AND EASEMENTS FOREVER ALL AREAS SO SHOWN OR INDICATED ON SAID PLAT, AND AUTHORIZE(S) THE CITY OF GREENSBORO TO RECORD THIS PLAT IN THE OFFICE OF THE REGISTER OF DEEDS OF GUILFORD COUNTY, N.C.

WHEN GRADE OF ADJACENT PROPERTY DOES NOT CONFORM TO THE STREET GRADE, AN EASEMENT IS EFFECTIVE FOR THE PURPOSE OF SLOPING EMBANKMENTS FROM STREET GRADE LEVEL AT THE PROPERTY LINE HAVING A SLOPE RATIO OF THREE FEET HORIZONTAL FOR EACH FOOT OF VERTICAL DIMENSION.

D. STONE BUILDERS, INC.

SIGNED *[Signature]*  
PRESIDENT  
ATTEST *[Signature]*  
SECRETARY



**EASEMENT DEDICATION & UTILIZATION**

EASEMENTS SHALL BE UTILIZED AND MAINTAINED IN ACCORDANCE WITH THE PROVISIONS OF AND DISCLAIMERS CONTAINED IN SECTION 30-6-13.7(B) AND (D) OF THE CITY OF GREENSBORO DEVELOPMENT ORDINANCE.

ALL EASEMENTS ARE MEASURED FROM THE CENTERLINE OF THE STRUCTURES OR ROAD UNLESS OTHERWISE NOTED.

APPROVED FOR RECORDATION BY THE CITY OF GREENSBORO, NORTH CAROLINA, ON THE 12th DAY OF Oct., 2009 PURSUANT TO THE GREENSBORO DEVELOPMENT ORDINANCE.

For *[Signature]*  
PLANNING DIRECTOR

I, NORRIS Z. CLAYTON, CERTIFY THAT THIS PLAT WAS DRAWN UNDER MY SUPERVISION FROM AN ACTUAL SURVEY MADE UNDER MY SUPERVISION (DEED DESCRIPTION RECORDED IN DEED BOOK 6262, PAGE 167, ETC.) (OTHER); THAT THE BOUNDARIES NOT SURVEYED ARE CLEARLY INDICATED AS DRAWN FROM INFORMATION FOUND IN BOOK NOTED.; THAT THE RATIO OF PRECISION AS CALCULATED IS 1: 10,000+; THAT THIS PLAT WAS PREPARED IN ACCORDANCE WITH G.S. 47-30 AS AMENDED.

I FURTHER CERTIFY THAT THIS SURVEY CREATES A SUBDIVISION OF LAND WITHIN THE AREA OF A COUNTY OR MUNICIPALITY THAT HAS AN ORDINANCE THAT REGULATES PARCELS OF LAND.

I CERTIFY THAT THE PLATS OR PLANS ACCURATELY DEPICT THE LEGAL BOUNDARIES AND THE PHYSICAL LOCATION OF THE UNITS AND OTHER IMPROVEMENTS RELATIVE TO THOSE BOUNDARIES.

WITNESS MY ORIGINAL SIGNATURE, REGISTRATION NUMBER AND SEAL THIS 7TH DAY OF OCTOBER, A.D. 2009

*[Signature]*  
SURVEYOR  
REGISTRATION NUMBER L-3189



**REVIEW OFFICER:**

CITY OF GREENSBORO, GUILFORD COUNTY, NC  
I, *[Signature]*, REVIEW OFFICER OF THE CITY OF GREENSBORO, NC, CERTIFY THAT THE MAP OR PLAT TO WHICH THIS CERTIFICATION IS AFFIXED MEETS ALL STATUTORY REQUIREMENTS FOR RECORDING.

DATE 10/12/09 *[Signature]*  
REVIEW OFFICER

THIS PLAT DOES NOT REQUIRE A CERTIFICATE OF APPROVAL BY THE DIVISION OF HIGHWAYS AS PROVIDED IN G.S. 136-102.6, SUB-

SIGNED *[Signature]* DATE 10/12/09  
For  
PLANNING DIRECTOR

NOTES:  
LINES BETWEEN PHASES HAVE NOT BEEN APPROVED AS PERMANENT PROPERTY LINES. D. STONE BUILDERS, INC. WILL DEVELOP AND CONVEY PROPERTY PHASE BY PHASE AT WHICH TIME SUCH PHASE WILL BE PLATTED AND RECORDED AS PART OF SEVEN GATES CONDOMINIUMS.



PHASING PLAN PREVIOUSLY RECORDED IN CPB 13 PG 131

THE COMMON ELEMENTS HAVE BEEN CONVEYED TO, AND WILL BE MAINTAINED BY THE SEVEN GATES HOMEOWNERS ASSOCIATION AS RECORDED IN DEED BOOK 6367 PAGE 1447-1485.

# NEW GARDEN ROAD


(PUBLIC R/W - VARIES)

PHASE LINES-NOT PROP. LINES

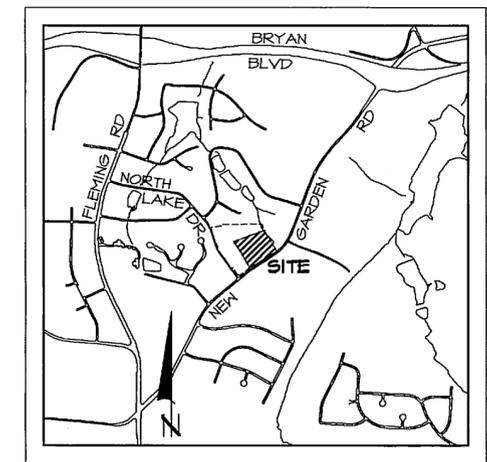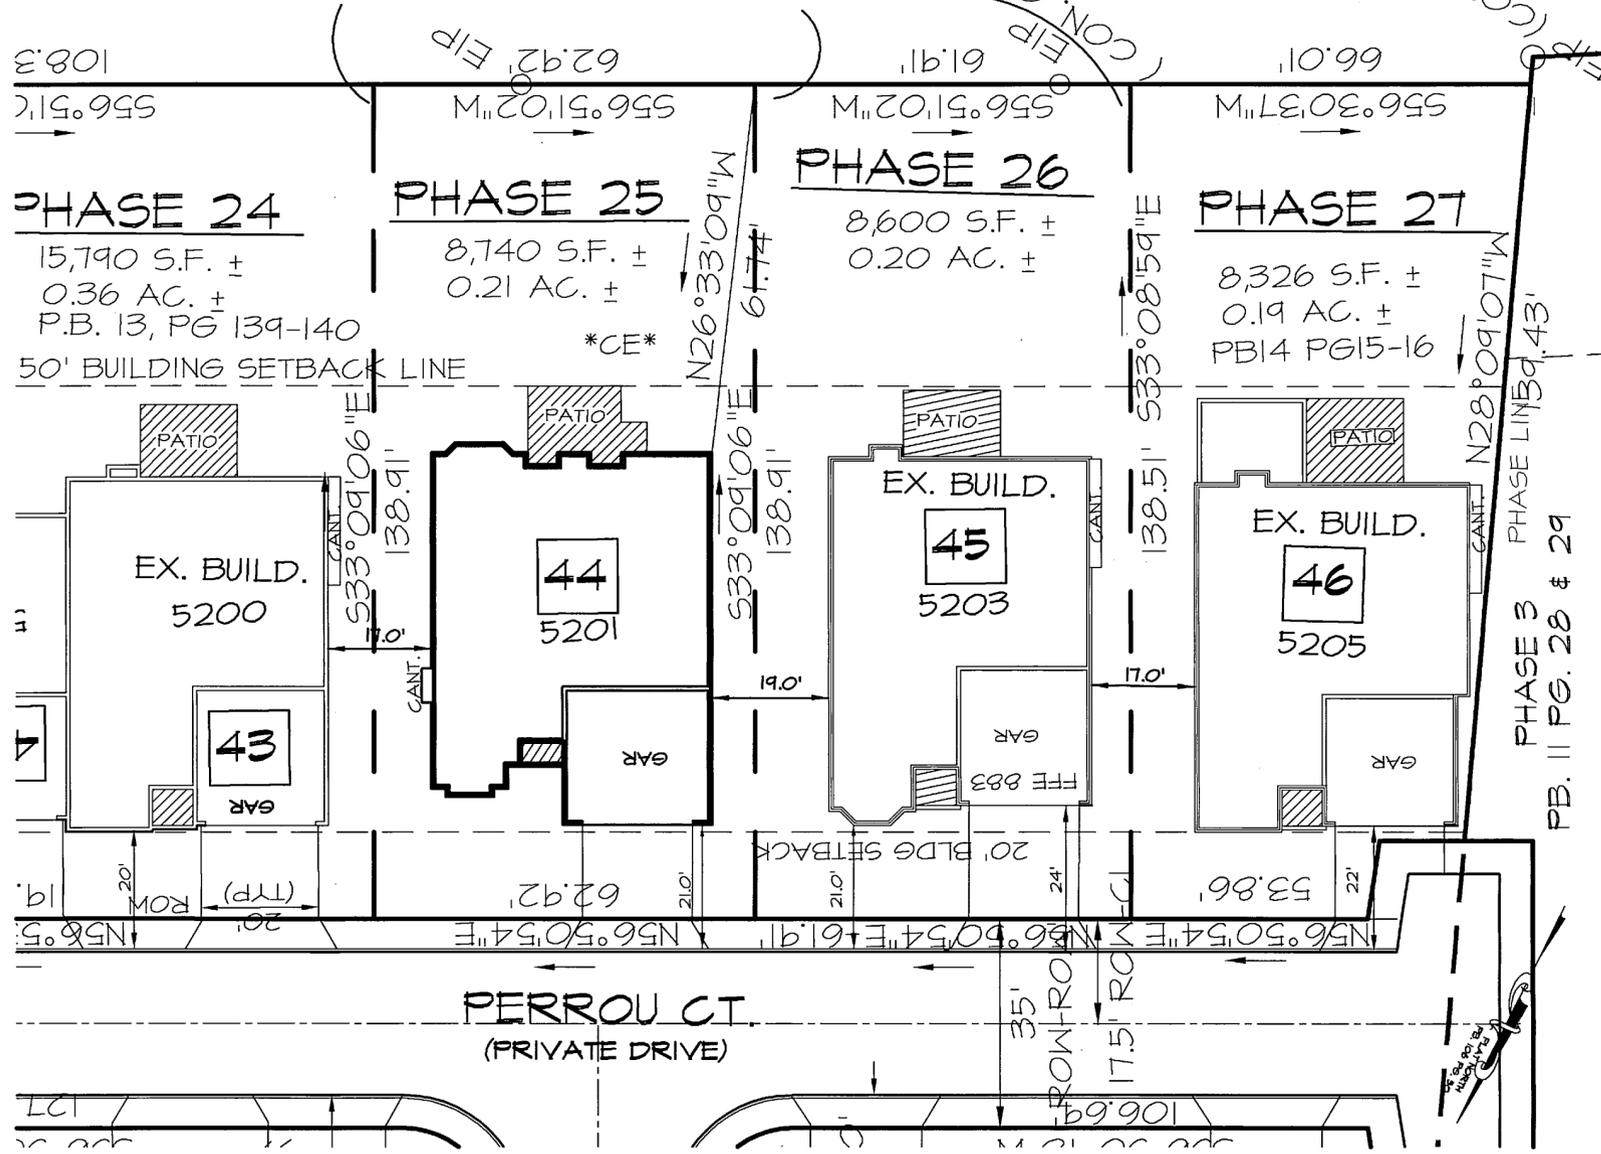

VICINITY MAP ~ 1" = 2,000'

ALL DIMENSIONS ARE EXTERIOR DIMENSIONS

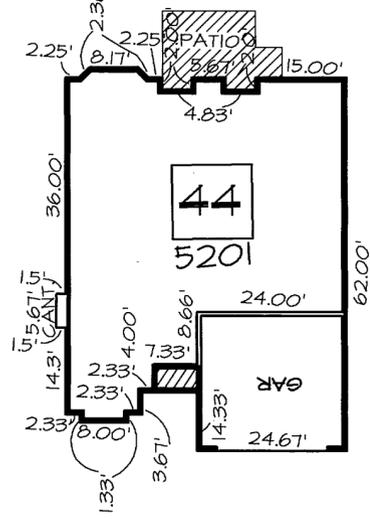

DL



2010019097  
GUILFORD CO, NC FEE \$42.00  
PRESERVED & RECORDED  
04-21-2010 09:19:07 AM  
JEFF L. THIGPEN  
REGISTER OF DEEDS  
BY DEBORAH LIGHT  
DEPUTY-GB

BK: C 14  
PG: 101-102

## FINAL PLAT SEVEN GATES A CONDOMINIUM PHASE 25 SHEET 1 OF 2

**D. STONE BUILDERS, INC.**

5201 PERROU CT.  
MOREHEAD TOWNSHIP, GUILFORD COUNTY  
GREENSBORO, NORTH CAROLINA  
SCALE: 1"=20' DATE: OCTOBER 7, 2009

**HUGH CREED ASSOCIATES, INC., P.A.**  
CONSULTING ENGINEERS & LAND SURVEYORS

P.O. BOX 9623  
1306 W. WENDOVER AVE.  
GREENSBORO, N.C. 27408  
FIRM LICENSE #C-0551  
PHONE: (336) 275-9826  
OR (336) 275-8084  
FAX: (336) 275-3379

B-1657-A

I HEREBY CERTIFY THAT THESE PLATS AND PLANS CONTAIN ALL OF THE INFORMATION REQUIRED UNDER N.C. GENERAL STATUTES SECTION 47C-2-104 AND THAT THESE PLATS AND PLANS FULLY AND ACCURATELY DEPICT THE LAYOUT, CEILING AND FLOOR ELEVATIONS, UNIT NUMBERS AND DIMENSIONS OF THE UNITS, AS BUILT. I FURTHER CERTIFY THAT ALL STRUCTURAL COMPONENTS AND MECHANICAL SYSTEMS OF ALL BUILDINGS ARE SUBSTANTIALLY COMPLETED IN ACCORDANCE WITH THESE PLANS.



*[Signature]*  
REGISTERED ENGINEER  
REGISTRATION NUMBER #10727  
OCTOBER 7, 2009  
DATE

AND IMPROVEMENTS THEREON TO A PLAN OF CONDOMINIUM UNDER THE PROVISIONS OF CHAPTER 47C OF THE NORTH CAROLINA GENERAL STATUTES (NORTH CAROLINA CONDOMINIUM ACT). THE CONDOMINIUM SHALL BE KNOWN AS SEVEN GATES, PHASE 25, AND IS COMPOSED OF CONDOMINIUM UNITS, COMMON ELEMENTS AND FACILITIES (LIMITED COMMON ELEMENTS). ALL OF THE PROPERTY OTHER THAN THAT SHOWN ON SUCCEEDING SHEETS AS "CONDOMINIUM UNITS" OR "UNITS" IS COMMON ELEMENTS OR LIMITED COMMON ELEMENTS. LIMITED COMMON ELEMENTS ARE SHOWN AS HATCHED AREAS.

EACH CONDOMINIUM IS RESTRICTED TO RESIDENTIAL USE BY THE OWNER THEREOF, HIS IMMEDIATE FAMILY, GUESTS, INVITEES AND LESSEES IN ACCORDANCE WITH THE PROVISIONS OF THE DECLARATION OF CONDOMINIUM DATED 7-19-06, AND RECORDED IN DEED BOOK 6367 PAGE 1447-1485 OF THE GUILFORD COUNTY REGISTRY.

THE COMMON ELEMENTS AND LIMITED COMMON ELEMENTS EXPRESSLY ARE NOT DEDICATED HEREBY FOR USE BY THE GENERAL PUBLIC, BUT ARE OWNED IN COMMON BY ALL OF THE UNIT OWNERS IN THE CONDOMINIUM TO BE USED, AS THE CASE MAY BE, BY ALL OR A CERTAIN PORTION OF THE UNIT OWNERS, AS EXPRESSLY PROVIDED FOR IN THE DECLARATION. FURTHER, THE PRIVATE STREETS SHOWN ON THIS PLAT ARE A PART OF THE COMMON ELEMENTS AND EXPRESSLY ARE NOT DEDICATED TO USE BY THE GENERAL PUBLIC, BUT ARE FOR INGRESS, EGRESS AND REGRESS FOR OWNERS OF UNITS IN ALL PHASES OF SEVEN GATES.

D. STONE BUILDERS, INC., BY RECORDATION OF THE DECLARATION OF CONDOMINIUM AND THIS PLAT, HEREBY GIVES, GRANTS, AND CONVEYS TO AT&T TELECOMMUNICATIONS, DUKE ENERGY, PIEDMONT NATURAL GAS COMPANY INC., THE-HARNER CABLE, AND THE CITY OF GREENSBORO, AND THEIR RESPECTIVE SUCCESSORS AND ASSIGNS, RIGHTS OF WAY AND EASEMENTS TO MAINTAIN AND SERVE THEIR RESPECTIVE LINES, WIRES, CONDUITS, AND PIPES IN THEIR PRESENT LOCATIONS INCLUDING THOSE WITHIN THE COMMON ELEMENTS AS SHOWN ON THIS PLAT, RECORDED IN THE GUILFORD COUNTY REGISTER OF DEEDS, AND THE SUCCEEDING SHEETS ATTACHED HERETO, TOGETHER WITH RIGHT OF INGRESS, EGRESS AND REGRESS INCLUDING OVER AND UPON SAID COMMON ELEMENTS FOR THE PURPOSE OF MAINTAINING AND SERVICING SAID LINES, WIRES, PIPES AND CONDUITS.

**LEGEND:**  
CE = COMMON ELEMENTS  
EIP = EXIST. IRON PIPE  
NIP = NEW IRON PIPE  
CH = CHORD DISTANCE  
CPB = CONDOMINIUM PLAT BOOK  
PB = PLAT BOOK  
DB = DEED BOOK  
PG = PAGE  
U = UNIT LABELS  
L = LIMITED COMMON ELEMENTS


**SETBACKS:**  
FRONT: 20'  
SIDE: 5'  
REAR: 50'

OWNERS:  
**D. STONE BUILDERS, INC.**  
2904 LAWNDALE DRIVE  
GREENSBORO, NC 27429  
PHONE (336) 288-9393


OCTOBER 7, 2008  
PROJECTS 2005-D STONE BUILDERS PHASE 25 SITES.DWG

I CERTIFY THAT THESE PLATS AND PLANS CONTAIN ALL OF THE INFORMATION REQUIRED UNDER N.C. GENERAL STATUTES SECTION 47C-2-109 AND THAT THESE PLATS AND PLANS FULLY AND ACCURATELY DEPICT THE LAYOUT, LOCATION, CEILING AND FLOOR ELEVATIONS, UNIT NUMBERS AND DIMENSIONS OF THE UNITS, AS BUILT. I FURTHER CERTIFY THAT THESE PLATS AND PLANS ACCURATELY DEPICT THE LEGAL BOUNDARIES OF THE CONDOMINIUM AND THE PHYSICAL LOCATIONS OF UNITS AND OTHER IMPROVEMENTS CONSTRUCTED WITHIN THE CONDOMINIUM RELATIVE TO THOSE BOUNDARIES. I FURTHER CERTIFY THAT ALL STRUCTURAL COMPONENTS AND MECHANICAL SYSTEMS OF ALL BUILDINGS ARE SUBSTANTIALLY COMPLETED IN ACCORDANCE WITH THESE PLANS.

*Norm J. Clifton*  
 PROFESSIONAL ENGINEER  
 REGISTRATION NUMBER #10727  
 JULY 7, 2009  
 DATE

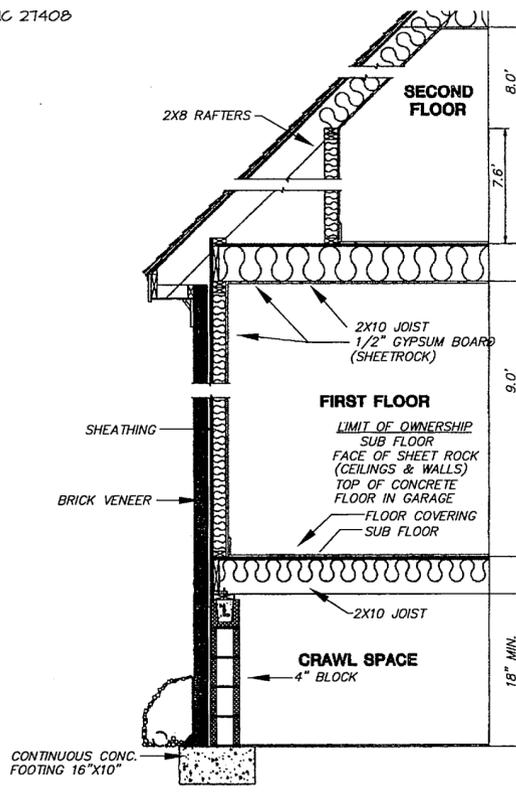

SECTION BRICK VENEER W/ CRAWL SPACE  
 EXTERIOR WALL SECTION  
 NO SCALE

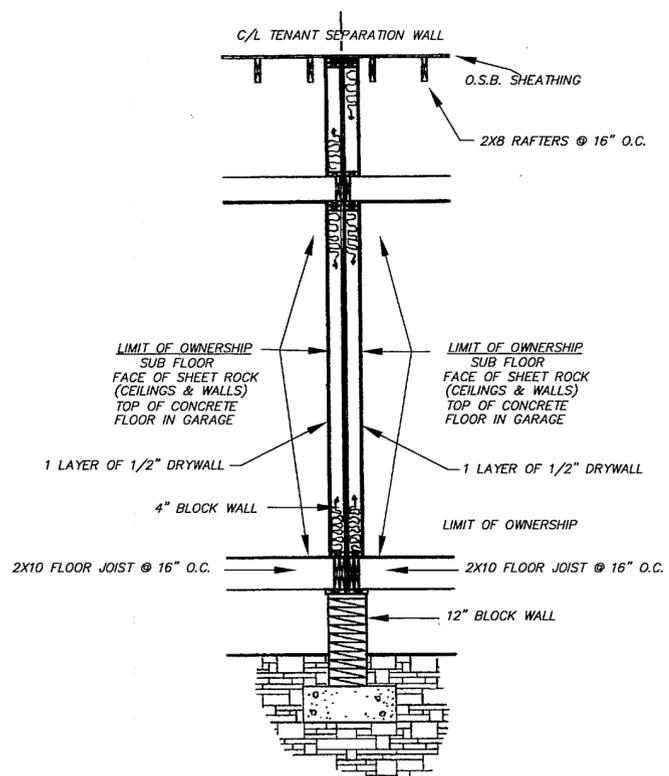



TENANT SEPARATION WALL DETAIL  
 NO SCALE

THE UNDERSIGNED HEREBY ACKNOWLEDGE(S) THIS PLAT AND ALLOTMENT TO BE THEIR FREE ACT AND DEED AND HEREBY DEDICATE(S) TO PUBLIC USE AS STREETS, PLAYGROUNDS, PARKS, OPEN SPACES, AND EASEMENTS FOREVER ALL AREAS SO SHOWN OR INDICATED ON SAID PLAT, AND AUTHORIZE(S) THE CITY OF GREENSBORO TO RECORD THIS PLAT IN THE OFFICE OF THE REGISTER OF DEEDS OF GUILFORD COUNTY, N.C. D.STONE BUILDERS, BY RECORDATION OF THIS PLAT, HEREBY GIVES, GRANTS AND CONVEYS TO AT&T, DUKE ENERGY, PIEDMONT NATURAL GAS COMPANY, TIME WARNER CABLE AND THE CITY OF GREENSBORO, THEIR RESPECTIVE SUCCESSORS AND ASSIGNS RIGHT-OF-WAY AND EASEMENTS TO RETAIN WIRES, LINES, CONDUITS AND PIPES IN THEIR PRESENT LOCATIONS, INCLUDING THOSE WITHIN THE "COMMON ELEMENTS" AND/OR "OPEN SPACES" AS SHOWN HEREON TOGETHER WITH THE RIGHT OF INGRESS AND EGRESS AS NECESSARY, INCLUDING OVER AND UPON SAID "COMMON ELEMENTS" AND/OR "OPEN SPACES" FOR THE PURPOSE OF MAINTAINING AND SERVICING SAID WIRES, LINES, CONDUITS AND PIPES.

D. STONE BUILDERS, INC.  
 SIGNED *[Signature]* PRESIDENT  
 ATTEST *[Signature]* SECRETARY



**LEGEND:**  
 F.F.E. = FINISHED FLOOR ELEVATION  
 F.C.E. = FINISHED CEILING ELEVATION  
 [Box] = UNIT LABELS  
 [Hatched Box] = LIMITED COMMON ELEMENTS

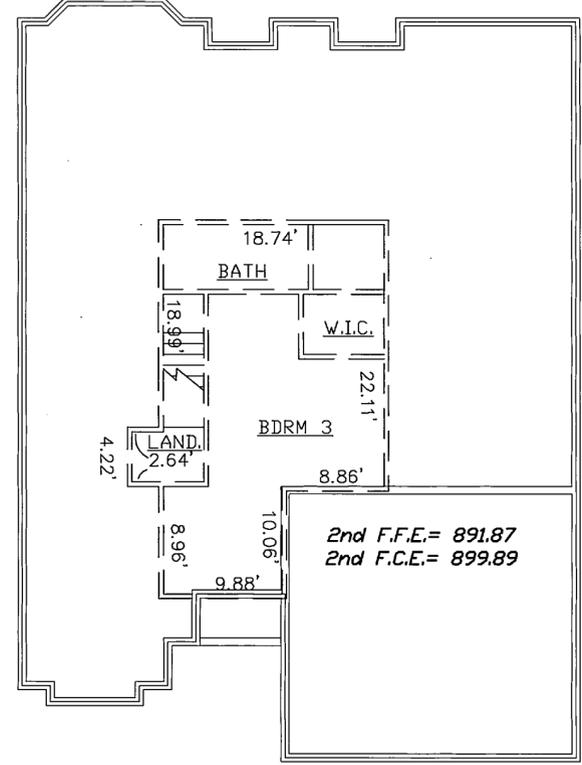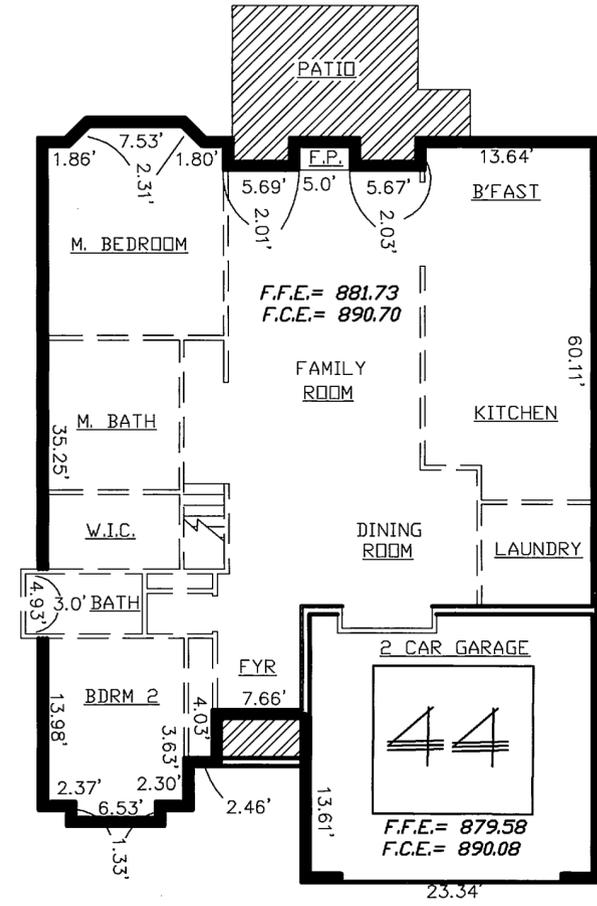

ALL DIMENSIONS ARE  
 INTERIOR DIMENSIONS  
 1"=10'

OWNERS:  
 D. STONE BUILDERS, INC.  
 2904 LANSDALE DRIVE  
 GREENSBORO, NC 27429  
 PHONE (336) 288-4393



**2010019097**  
 GUILFORD CO, NC FEE \$42.00  
 PRESENTED & RECORDED:  
 04-21-2010 09:19:07 AM  
 JEFF L. THIGPEN  
 REGISTER OF DEEDS  
 BY: DEBORAH LIGHT  
 08/27/09  
 BK: C 14  
 PG: 101-102

**FINAL PLAT**  
**SEVEN GATES**  
 A CONDOMINIUM  
 PHASE 25  
 SHEET 2 OF 2  
**D. STONE BUILDERS, INC.**

5201 FERROU CT.  
 MOREHEAD TOWNSHIP, GUILFORD COUNTY  
 GREENSBORO, NORTH CAROLINA  
 SCALE: AS NOTED DATE: OCTOBER 7, 2009  
**HUGH CREED ASSOCIATES, INC., P.A.**  
 CONSULTING ENGINEERS & LAND SURVEYORS

P.O. BOX 9623 GREENSBORO, N.C. 27408  
 PHONE: (336) 275-9826 OR (336) 275-8084  
 FAX: (336) 275-3379  
 FIRM LICENSE #C-0551

OCTOBER 7, 2009 P:\PROJECTS\2005\VD STONETOWN GATES PHASE2\PHASE2 SITES.DWG

DL