

OWNERSHIP AND DEDICATION

THE UNDERSIGNED HEREBY ACKNOWLEDGE(S) THIS PLAT AND ALLOTMENT TO BE IT'S FREE ACT AND DEED AND HEREBY DEDICATE(S) TO PUBLIC USE AS STREETS, PLAYGROUNDS, PARKS, OPEN SPACES, AND EASEMENTS FOREVER ALL AREAS SO SHOWN OR INDICATED ON SAID PLAT, AND AUTHORIZE(S) THE CITY OF GREENSBORO TO RECORD THIS PLAT IN THE OFFICE OF THE REGISTER OF DEEDS OF GUILFORD COUNTY, N.C.

WHEN GRADE OF ADJACENT PROPERTY DOES NOT CONFORM TO THE STREET GRADE, AN EASEMENT IS EFFECTIVE FOR THE PURPOSE OF SLOPING EMBANKMENTS FROM STREET GRADE LEVEL AT THE PROPERTY LINE HAVING A SLOPE RATIO OF THREE FEET HORIZONTAL FOR EACH FOOT OF VERTICAL DIMENSION.

D. STONE BUILDERS, INC.

SIGNED [Signature]
PRESIDENT / VICE-PRESIDENT
ATTEST [Signature]
SECRETARY



EASEMENT UTILIZATION & MAINTENANCE

EASEMENTS SHALL BE UTILIZED AND MAINTAINED IN ACCORDANCE WITH THE PROVISIONS OF AND DISCLAIMERS CONTAINED IN SECTION 30-12-8.1 (B) AND (D) OF THE CITY OF GREENSBORO LAND DEVELOPMENT ORDINANCE.

ALL EASEMENTS ARE MEASURED FROM THE CENTERLINE OF THE STRUCTURES OR ROAD UNLESS OTHERWISE NOTED.

APPROVED FOR RECORDATION BY THE CITY OF GREENSBORO, NORTH CAROLINA, ON THE 22nd DAY OF Sept, 2011
PURSUANT TO THE GREENSBORO DEVELOPMENT ORDINANCE.

[Signature]
PLANNING DIRECTOR

I, NORRIS Z. CLAYTON, CERTIFY THAT THIS PLAT WAS DRAWN UNDER MY SUPERVISION FROM AN ACTUAL SURVEY MADE UNDER MY SUPERVISION (DEED DESCRIPTION RECORDED IN DEED BOOK 6262, PAGE 167, ETC.) (OTHER); THAT THE BOUNDARIES NOT SURVEYED ARE CLEARLY INDICATED AS DRAWN FROM INFORMATION FOUND IN BOOK NOTED; THAT THE RATIO OF PRECISION AS CALCULATED IS 1: 10,000+; THAT THIS PLAT WAS PREPARED IN ACCORDANCE WITH G.S. 47-30 AS AMENDED.

I FURTHER CERTIFY THAT THIS SURVEY CREATES A SUBDIVISION OF LAND WITHIN THE AREA OF A COUNTY OR MUNICIPALITY THAT HAS AN ORDINANCE THAT REGULATES PARCELS OF LAND.

I CERTIFY THAT THE PLATS OR PLANS ACCURATELY DEPICT THE LEGAL BOUNDARIES AND THE PHYSICAL LOCATION OF THE UNITS AND OTHER IMPROVEMENTS RELATIVE TO THOSE BOUNDARIES.

WITNESS MY ORIGINAL SIGNATURE, REGISTRATION NUMBER AND SEAL THIS 30TH DAY OF AUGUST, A.D. 2011

[Signature]
SURVEYOR
REGISTRATION NUMBER L-3189



REVIEW OFFICER:

CITY OF GREENSBORO, GUILFORD COUNTY, NC
I, Nicole Wade, REVIEW OFFICER OF THE CITY OF GREENSBORO, NC, CERTIFY THAT THE MAP OR PLAT TO WHICH THIS CERTIFICATION IS AFFIXED MEETS ALL STATUTORY REQUIREMENTS FOR RECORDING.

DATE 9/22/11
REVIEW OFFICER

THIS PLAT DOES NOT REQUIRE A CERTIFICATE OF APPROVAL BY THE DIVISION OF HIGHWAYS AS PROVIDED IN G.S. 136-102.6, SUB-

SIGNED [Signature] DATE 9-22-11
PLANNING DIRECTOR

NOTES:

LINE BETWEEN PHASES HAVE NOT BEEN APPROVED AS PERMANENT PROPERTY LINES. D. STONE BUILDERS, INC. WILL DEVELOP AND CONVEY PROPERTY PHASE BY PHASE AT WHICH TIME EACH PHASE WILL BE PLATTED AND RECORDED AS PART OF SEVEN GATES CONDOMINIUMS.

PHASING PLAN PREVIOUSLY RECORDED IN CPB. 13 PG 131

THE COMMON ELEMENTS WILL BE MAINTAINED BY THE SEVEN GATES HOMEOWNERS ASSOCIATION AS RECORDED IN DEED BOOK 6561 PAGE 1447-1485.


AND IMPROVEMENTS THEREON TO A PLAN OF CONDOMINIUM UNDER THE PROVISIONS OF CHAPTER 47C OF THE NORTH CAROLINA GENERAL STATUTES (NORTH CAROLINA CONDOMINIUM ACT). THE CONDOMINIUM SHALL BE KNOWN AS SEVEN GATES, PHASE 28, AND IS COMPOSED OF CONDOMINIUM UNITS, COMMON ELEMENTS AND FACILITIES (LIMITED COMMON ELEMENTS). ALL OF THE PROPERTY OTHER THAN THAT SHOWN ON SUCCEEDING SHEETS AS "CONDOMINIUM UNITS" OR "UNITS" IS COMMON ELEMENTS OR LIMITED COMMON ELEMENTS. LIMITED COMMON ELEMENTS ARE SHOWN AS HATCHED AREAS.

EACH CONDOMINIUM IS RESTRICTED TO RESIDENTIAL USE BY THE OWNER THEREOF, HIS IMMEDIATE FAMILY, GUESTS, INVITEES AND LESSEES IN ACCORDANCE WITH THE PROVISIONS OF THE DECLARATION OF CONDOMINIUM DATED 7-19-06, AND RECORDED IN DEED BOOK 6561 PAGE 1447-1485 OF THE GUILFORD COUNTY REGISTRY.

THE COMMON ELEMENTS AND LIMITED COMMON ELEMENTS EXPRESSLY ARE NOT DEDICATED HEREBY FOR USE BY THE GENERAL PUBLIC, BUT ARE OWNED IN COMMON BY ALL OF THE UNIT OWNERS IN THE CONDOMINIUM, TO BE USED, AS THE CASE MAY BE, BY ALL OR A CERTAIN PORTION OF THE UNIT OWNERS, AS EXPRESSLY PROVIDED FOR IN THE DECLARATION. FURTHER, THE PRIVATE STREETS SHOWN ON THIS PLAT ARE A PART OF THE COMMON ELEMENTS AND EXPRESSLY ARE NOT DEDICATED TO USE BY THE GENERAL PUBLIC, BUT ARE FOR INGRESS, EGRESS AND REGRESS FOR OWNERS OF UNITS IN ALL PHASES OF SEVEN GATES.

D. STONE BUILDERS, INC., BY RECORDATION OF THE DECLARATION OF CONDOMINIUM AND THIS PLAT, HEREBY GIVES, GRANTS, AND CONVEYS TO AT&T TELECOMMUNICATIONS, DUKE ENERGY, FIDMONT NATURAL GAS COMPANY INC., TIME-WARNER CABLE, AND THE CITY OF GREENSBORO, AND THEIR RESPECTIVE SUCCESSORS AND ASSIGNS, RIGHTS OF WAY AND EASEMENTS TO MAINTAIN AND SERVE THEIR RESPECTIVE LINES, WIRES, CONDUITS, AND PIPES IN THEIR PRESENT LOCATIONS INCLUDING THOSE WITHIN THE COMMON ELEMENTS AS SHOWN ON THIS PLAT, RECORDED IN THE GUILFORD COUNTY REGISTER OF DEEDS, AND THE SUCCEEDING SHEETS ATTACHED HERETO, TOGETHER WITH RIGHT OF INGRESS, EGRESS AND REGRESS INCLUDING OVER AND UPON SAID COMMON ELEMENTS FOR THE PURPOSE OF MAINTAINING AND SERVICING SAID LINES, WIRES, PIPES AND CONDUITS.


I HEREBY CERTIFY THAT THESE PLATS AND PLANS CONTAIN ALL OF THE INFORMATION REQUIRED UNDER N.C. GENERAL STATUTES SECTION 47C-2-109 AND THAT THESE PLATS AND PLANS FULLY AND ACCURATELY DEPICT THE LAYOUT, CEILING AND FLOOR ELEVATIONS, UNIT NUMBERS AND DIMENSIONS OF THE UNITS, AS BUILT. I FURTHER CERTIFY THAT ALL STRUCTURAL COMPONENTS AND MECHANICAL SYSTEMS OF ALL BUILDINGS ARE SUBSTANTIALLY COMPLETED IN ACCORDANCE WITH THESE PLANS.

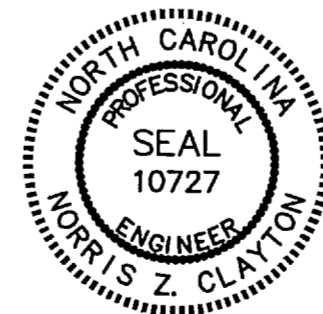

[Signature]
REGISTERED ENGINEER
REGISTRATION NUMBER #10727
AUGUST 31, 2011
DATE


LEGEND:
CE = COMMON ELEMENTS
EIP = EXIST. IRON PIPE
NIP = NEW IRON PIPE
CH = CHORD DISTANCE
CPB = CONDOMINIUM PLAT BOOK
FB = PLAT BOOK
DB = DEED BOOK
PG. = PAGE
□ = UNIT LABELS
CON. COR. = CONTROL CORNER
CONC. D/W = CONCRETE DRIVEWAY

SETBACKS:
FRONT: 20'
SIDE: 15'
REAR: 50'

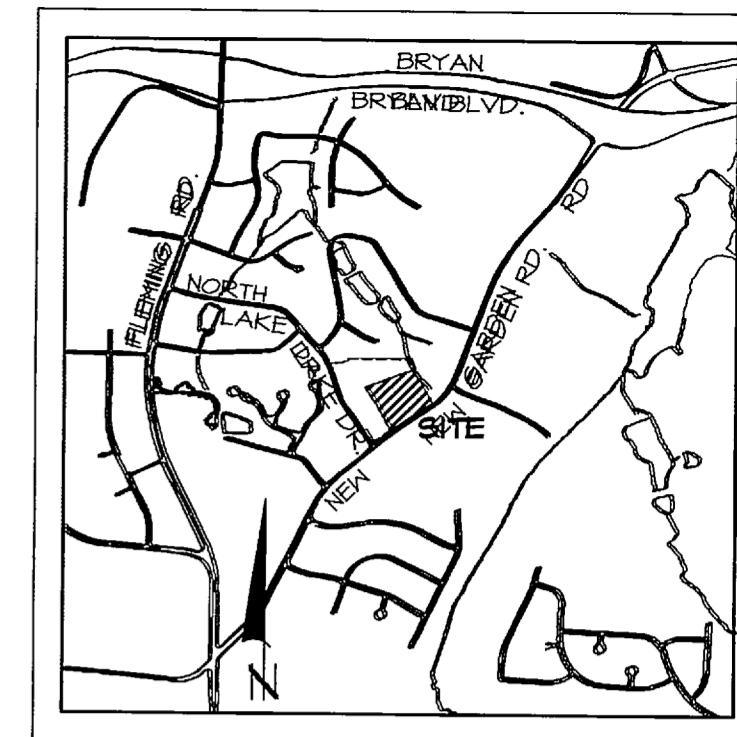

VICINITY MAP ~ 1" = 2,000'

ALL DIMENSIONS ARE EXTERIOR DIMENSIONS

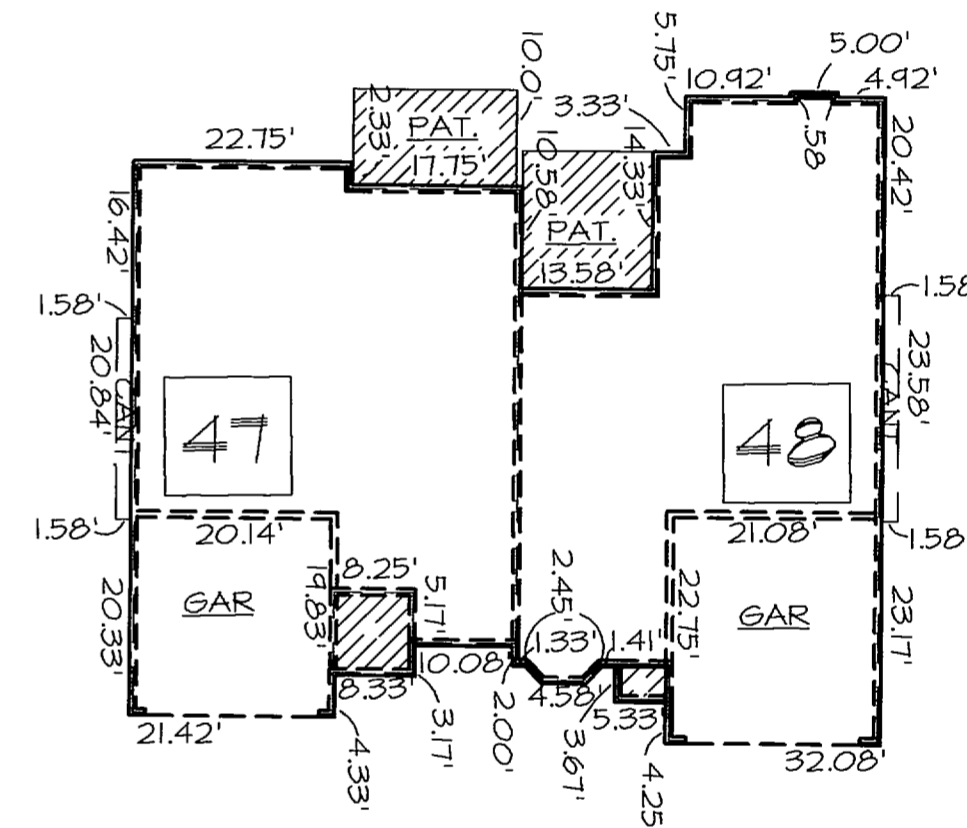

2011049013
GUILFORD CO, NC FEE \$42.00
PRESENTED & RECORDED
09-22-2011 08:44:54 AM
JEFF L. THIGPEN
REGISTER OF DEEDS
BY: TERESA STEELMAN
DEPUTY-GB

BK: C 15
PG: 9-10

FINAL PLAT
SEVEN GATES
A CONDOMINIUM
PHASE 28
SHEET 1 OF 2

D. STONE BUILDERS, INC.

5207 & 5209 PERROU CT.
MOREHEAD TOWNSHIP, GUILFORD COUNTY
GREENSBORO, NORTH CAROLINA

SCALE: 1"=20' DATE: AUGUST 30, 2011

0 10' 20' 40'

HUGH CREED ASSOCIATES, INC., P.A.
CONSULTING ENGINEERS & LAND SURVEYORS

P.O. BOX 9623
1306 W. WENDOVER AVE.
GREENSBORO, N.C. 27408
FIRM LICENSE #C-0551
PHONE: (336) 275-9826
OR (336) 275-8084
FAX: (336) 275-3379
E-MAIL: HCA@TRIADBIZ.RR.COM

PICK UP - HUGH CREED ASSOCIATES, INC., P.A. 1306 W. WENDOVER AVE. GREENSBORO, NC 27408

I CERTIFY THAT THESE PLATS AND PLANS CONTAIN ALL OF THE INFORMATION REQUIRED UNDER N.C. GENERAL STATUTES SECTION 47C-2-109 AND THAT THESE PLATS AND PLANS FULLY AND ACCURATELY DEPICT THE LAYOUT, LOCATION, CEILING AND FLOOR ELEVATIONS, UNIT NUMBERS AND DIMENSIONS OF THE UNITS, AS BUILT. I FURTHER CERTIFY THAT THESE PLATS AND PLANS ACCURATELY DEPICT THE LEGAL BOUNDARIES OF THE CONDOMINIUM AND THE PHYSICAL LOCATIONS OF UNITS AND OTHER IMPROVEMENTS CONSTRUCTED WITHIN THE CONDOMINIUM RELATIVE TO THOSE BOUNDARIES. I FURTHER CERTIFY THAT ALL STRUCTURAL COMPONENTS AND MECHANICAL SYSTEMS OF ALL BUILDINGS ARE SUBSTANTIALLY COMPLETED IN ACCORDANCE WITH THESE PLANS.

Thomas J. Clayton
PROFESSIONAL ENGINEER
REGISTRATION NUMBER #10727
AUGUST 30, 2011
DATE



THE UNDERSIGNED HEREBY ACKNOWLEDGE(S) THIS PLAT AND ALLOTMENT TO BE THEIR FREE ACT AND DEED AND HEREBY DEDICATE(S) TO PUBLIC USE AS STREETS, PLAYGROUNDS, PARKS, OPEN SPACES, AND EASEMENTS FOREVER ALL AREAS SO SHOWN OR INDICATED ON SAID PLAT, AND AUTHORIZE(S) THE CITY OF GREENSBORO TO RECORD THIS PLAT IN THE OFFICE OF THE REGISTER OF DEEDS OF GUILFORD COUNTY, N.C. D.STONE BUILDERS, BY RECORDATION OF THIS PLAT, HEREBY GIVES, GRANTS AND CONVEYS TO AT&T, DUKE ENERGY, PIEDMONT NATURAL GAS COMPANY, TIME WARNER CABLE AND THE CITY OF GREENSBORO, THEIR RESPECTIVE SUCCESSORS AND ASSIGNS RIGHT-OF-WAY AND EASEMENTS TO RETAIN WIRES, LINES, CONDUITS AND PIPES IN THEIR PRESENT LOCATIONS, INCLUDING THOSE WITHIN THE "COMMON ELEMENTS" AND/OR "OPEN SPACES" AS SHOWN HEREON TOGETHER WITH THE RIGHT OF INGRESS AND EGRESS AS NECESSARY, INCLUDING OVER AND UPON SAID "COMMON ELEMENTS" AND/OR "OPEN SPACES" FOR THE PURPOSE OF MAINTAINING AND SERVICING SAID WIRES, LINES, CONDUITS AND PIPES.


D. STONE BUILDERS, INC.

SIGNED *[Signature]*
PRESIDENT / VICE-PRESIDENT


ATTEST *[Signature]*
SECRETARY



ALL DIMENSIONS ARE
INTERIOR DIMENSIONS
1"=10'

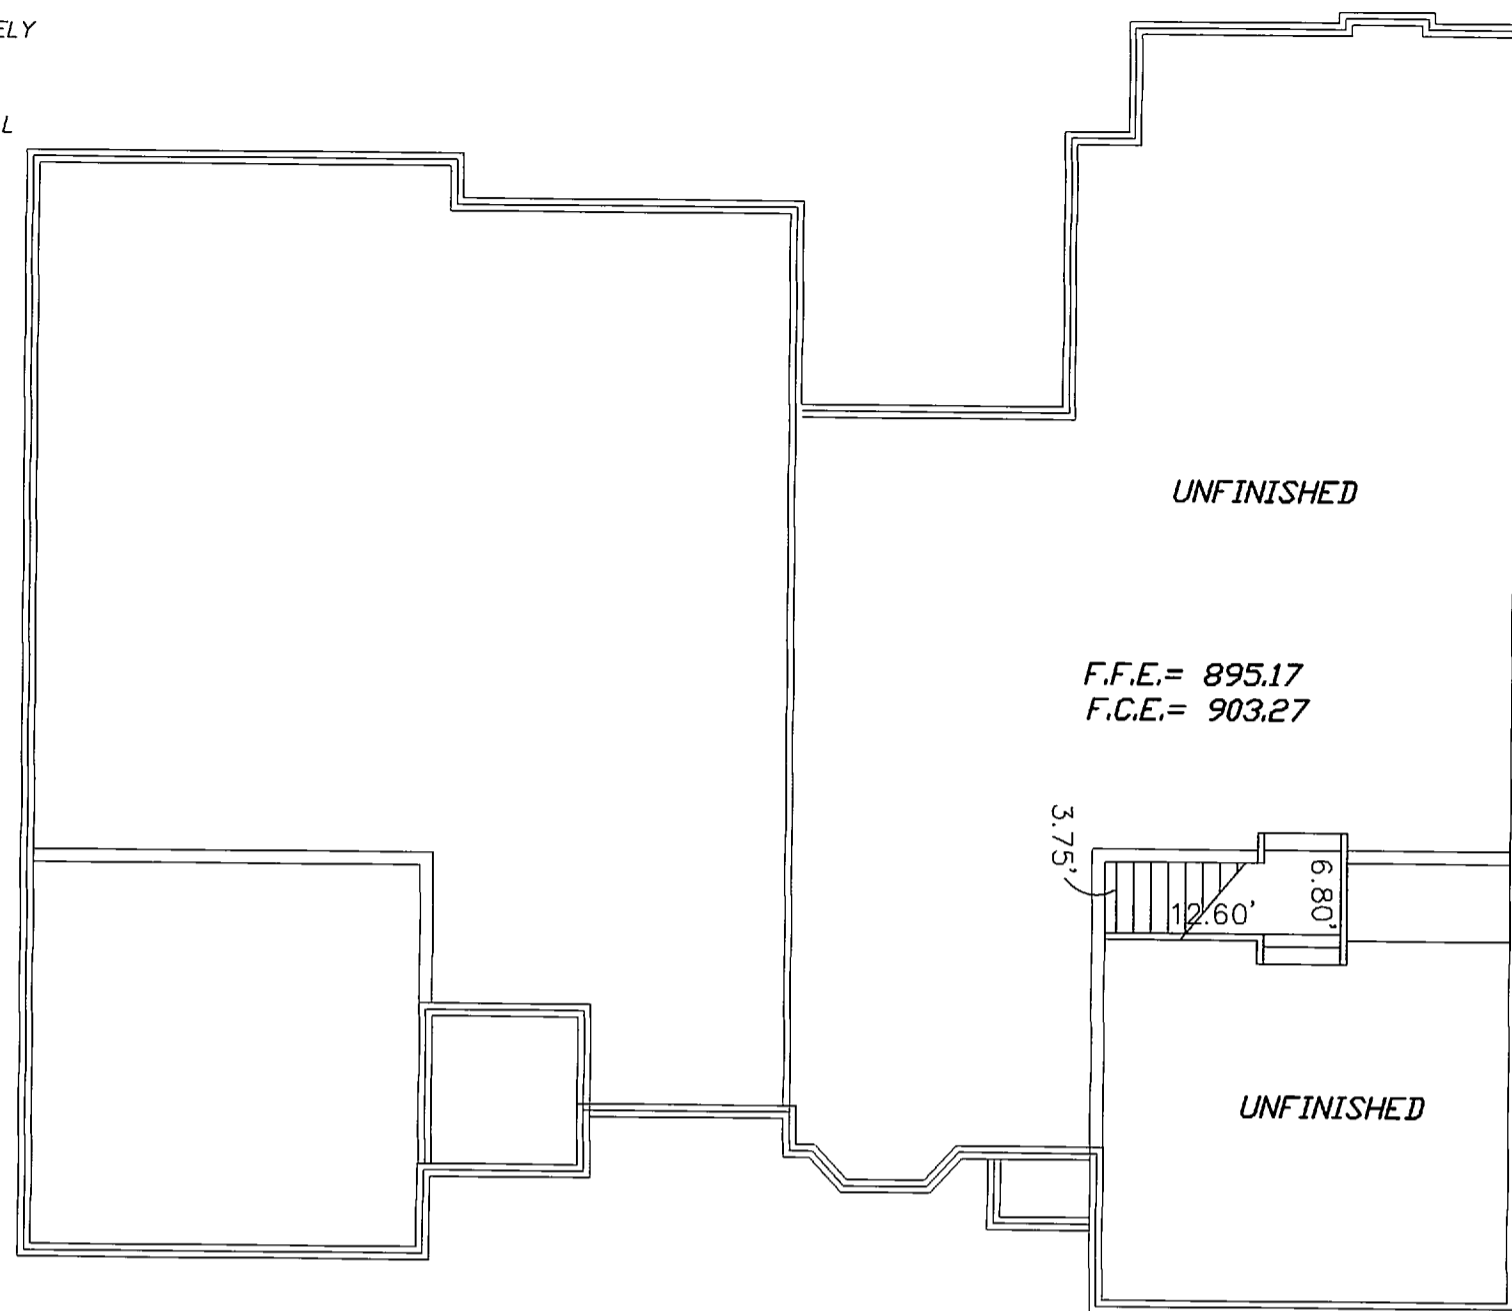


2nd FLOOR

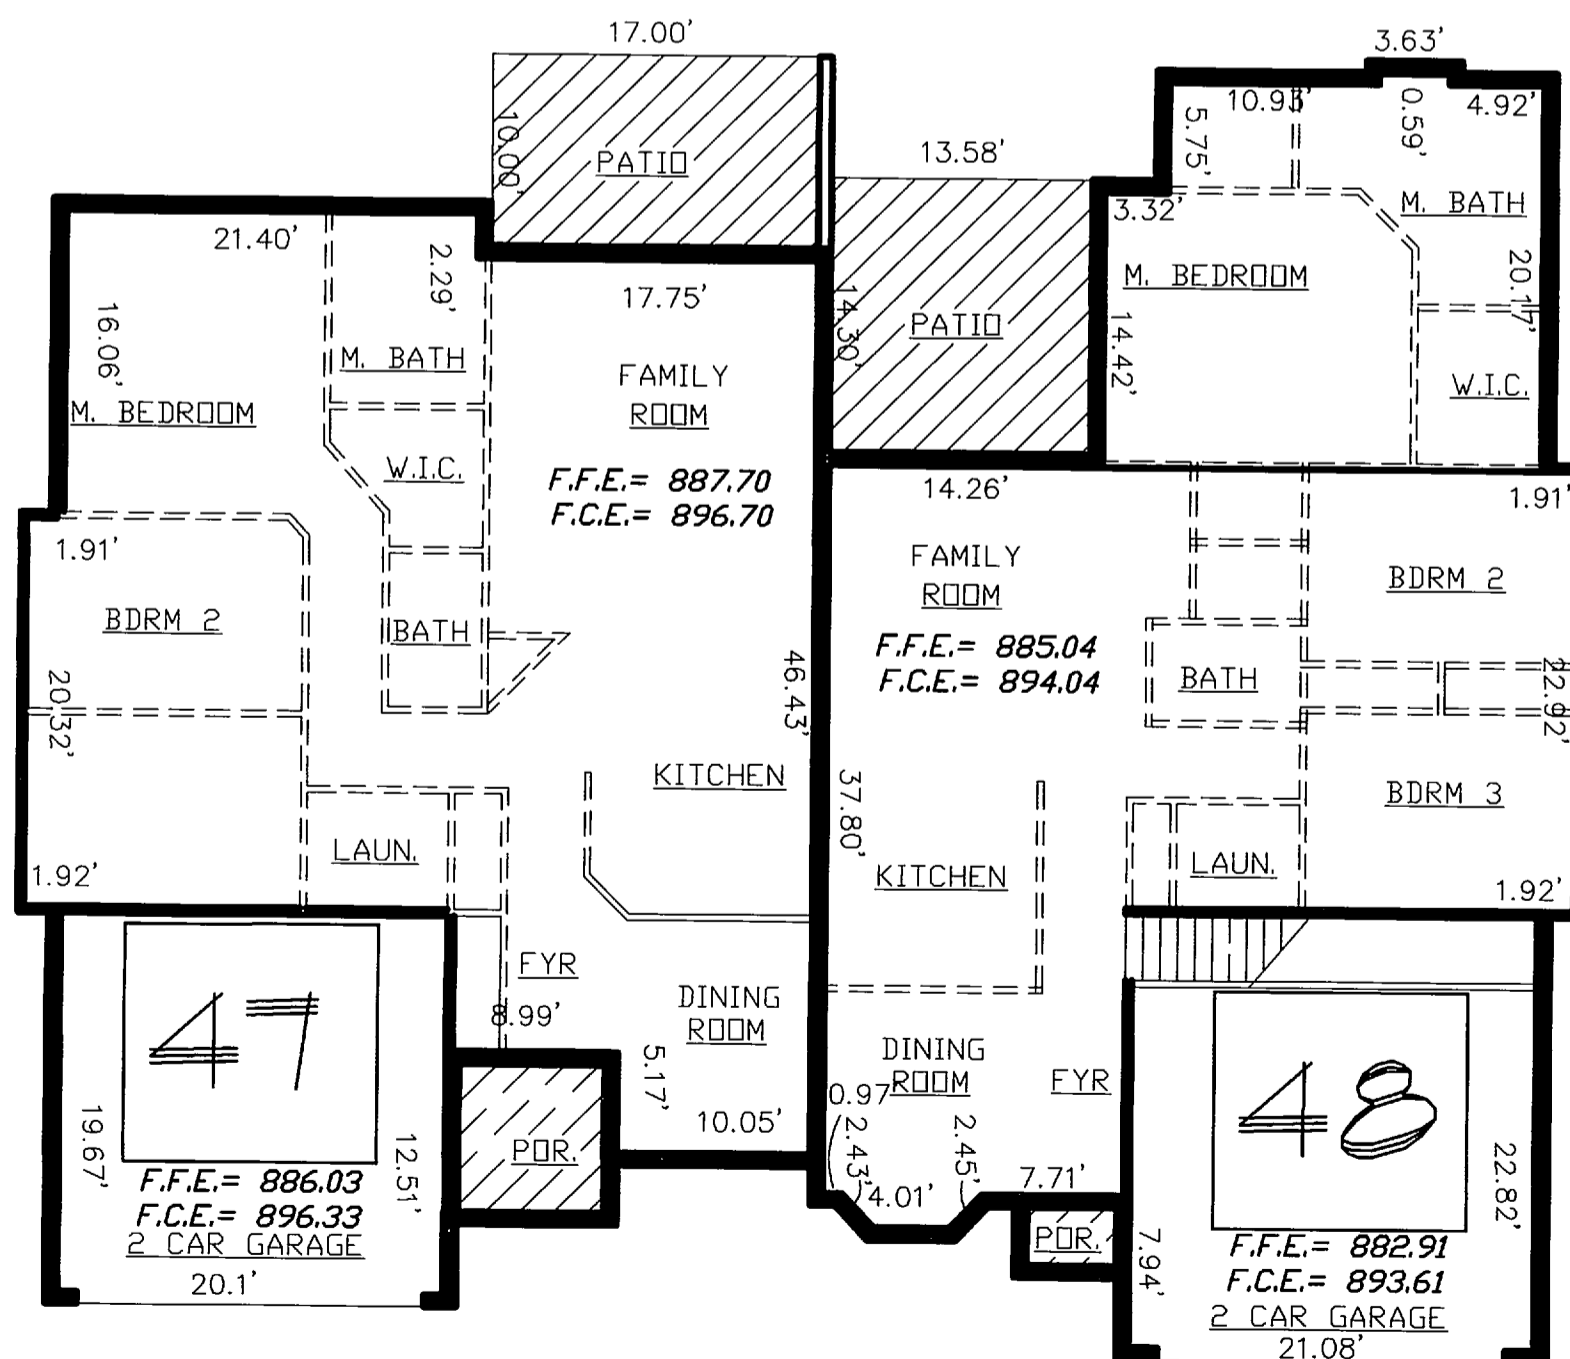


1st FLOOR

CONDOMINIUM PLAT BOOK 15, PAGE 10

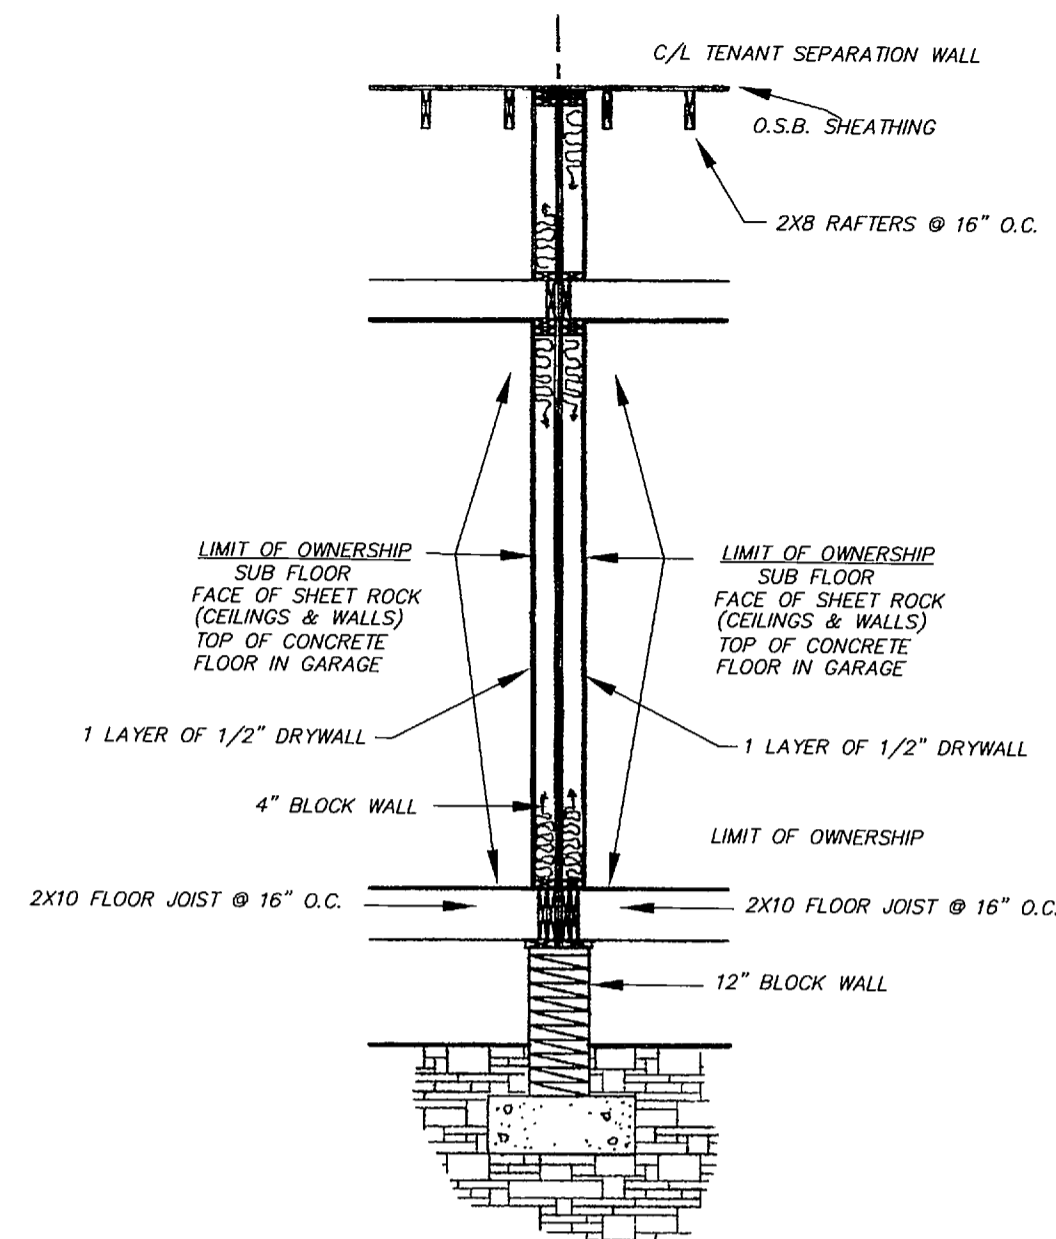

TENANT SEPARATION WALL DETAIL
NO SCALE

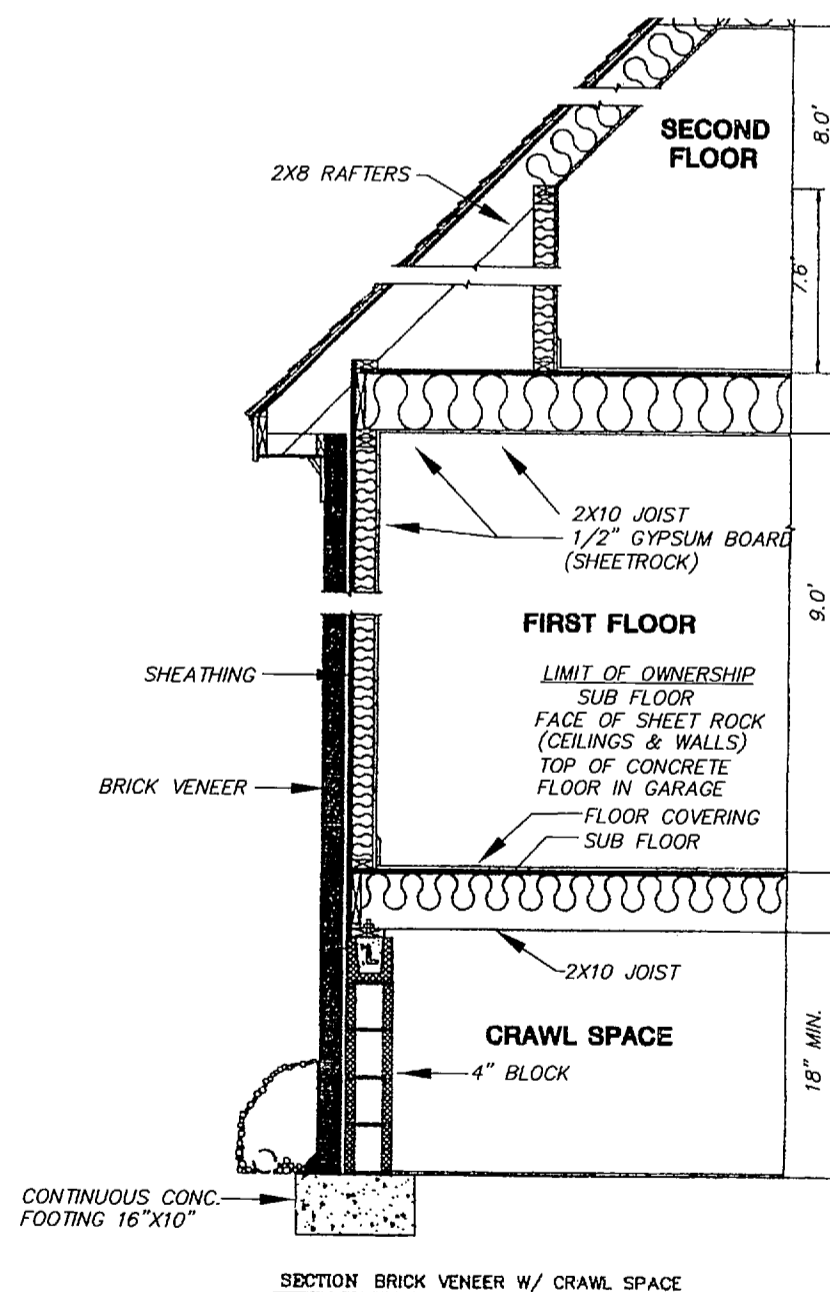

EXTERIOR WALL SECTION
NO SCALE

LEGEND:
F.F.E. = FINISHED FLOOR ELEVATION
F.C.E. = FINISHED CEILING ELEVATION
[] = UNIT LABELS
[] = LIMITED COMMON ELEMENTS

OWNERS:
D. STONE BUILDERS, INC.
2904 LAMDALE DRIVE
GREENSBORO, NC 27429
PHONE (336) 288-4343



2011049013
GUILFORD CO, NC FEE \$42.00
PRESENTED & RECORDED:
09-22-2011 08:44:54 AM
JEFF L. THIGPEN
REGISTER OF DEEDS
BY TERESA STEELMAN
DEPUTY-GB
BK: C 15
PG: 9-10

FINAL PLAT
SEVEN GATES
A CONDOMINIUM
PHASE 28
SHEET 2 OF 2

D. STONE BUILDERS, INC.

5207 & 5209 FERROU CT.
MOREHEAD TOWNSHIP, GUILFORD COUNTY
GREENSBORO, NORTH CAROLINA

SCALE: AS NOTED DATE: AUGUST 30, 2011

HUGH CREED ASSOCIATES, INC., P.A.
CONSULTING ENGINEERS & LAND SURVEYORS

P.O. BOX 9623
1306 W. WENDOVER AVE.
GREENSBORO, N.C. 27408
FIRM LICENSE #C-0551

PHONE: (336) 275-9826
OR (336) 275-8084
FAX: (336) 275-3379
E-MAIL: HCA@TRIADBIZ.RR.COM

B-1699 B