

OCTOBER 7, 2008
PROJECTS 2005\D STONE\GATES PHASE2\ PHASE2 SITE3.DWG

PICK UP - HUGH CREED ASSOCIATES, INC., P.A. 1306 W. WENDOVER AVE. GREENSBORO, NC 27408

CONDOMINIUM PLAT BOOK 14, PAGE 38

OWNERSHIP AND DEDICATION

THE UNDERSIGNED HEREBY ACKNOWLEDGE(S) THIS PLAT AND ALLOTMENT TO BE ITS FREE ACT AND DEED AND HEREBY DEDICATE(S) TO PUBLIC USE AS STREETS, PLAYGROUNDS, PARKS, OPEN SPACES, AND EASEMENTS FOREVER ALL AREAS SO SHOWN OR INDICATED ON SAID PLAT, AND AUTHORIZE(S) THE CITY OF GREENSBORO TO RECORD THIS PLAT IN THE OFFICE OF THE REGISTER OF DEEDS OF GUILFORD COUNTY, N.C.

WHEN GRADE OF ADJACENT PROPERTY DOES NOT CONFORM TO THE STREET GRADE, AN EASEMENT IS EFFECTIVE FOR THE PURPOSE OF SLOPING EMBANKMENTS FROM STREET GRADE LEVEL AT THE PROPERTY LINE HAVING A SLOPE RATIO OF THREE FEET HORIZONTAL FOR EACH FOOT OF VERTICAL DIMENSION.

D. STONE BUILDERS, INC.

SIGNED [Signature] PRESIDENT
ATTEST [Signature] SECRETARY



EASEMENT DEDICATION & UTILIZATION

EASEMENTS SHALL BE UTILIZED AND MAINTAINED IN ACCORDANCE WITH THE PROVISIONS OF AND DISCLAIMERS CONTAINED IN SECTION 30-6-13.7(B) AND (D) OF THE CITY OF GREENSBORO DEVELOPMENT ORDINANCE.

ALL EASEMENTS ARE MEASURED FROM THE CENTERLINE OF THE STRUCTURES OR ROAD UNLESS OTHERWISE NOTED.

APPROVED FOR RECORDATION BY THE CITY OF GREENSBORO, NORTH CAROLINA, ON THE 3rd DAY OF MAR. 2009, PURSUANT TO THE GREENSBORO DEVELOPMENT ORDINANCE.

FOR PLANNING DIRECTOR

I, NORRIS Z. CLAYTON, CERTIFY THAT THIS PLAT WAS DRAWN UNDER MY SUPERVISION FROM AN ACTUAL SURVEY MADE UNDER MY SUPERVISION (DEED DESCRIPTION RECORDED IN DEED BOOK 6262, PAGE 167, ETC.) (OTHER); THAT THE BOUNDARIES NOT SURVEYED ARE CLEARLY INDICATED AS DRAWN FROM INFORMATION FOUND IN BOOK NOTED; THAT THE RATIO OF PRECISION AS CALCULATED IS 1: 10,000+; THAT THIS PLAT WAS PREPARED IN ACCORDANCE WITH G.S. 47-30 AS AMENDED.

I FURTHER CERTIFY THAT THIS SURVEY CREATES A SUBDIVISION OF LAND WITHIN THE AREA OF A COUNTY OR MUNICIPALITY THAT HAS AN ORDINANCE THAT REGULATES PARCELS OF LAND.

I CERTIFY THAT THE PLATS OR PLANS ACCURATELY DEPICT THE LEGAL BOUNDARIES AND THE PHYSICAL LOCATION OF THE UNITS AND OTHER IMPROVEMENTS RELATIVE TO THOSE BOUNDARIES.

WITNESS MY ORIGINAL SIGNATURE, REGISTRATION NUMBER AND SEAL THIS 6TH DAY OF FEBRUARY, A.D. 2009

SURVEYOR
REGISTRATION NUMBER 3182



REVIEW OFFICER:

CITY OF GREENSBORO, GUILFORD COUNTY, NC
I, Devin Reid, REVIEW OFFICER OF THE CITY OF GREENSBORO, NC, CERTIFY THAT THE MAP OR PLAT TO WHICH THIS CERTIFICATION IS AFFIXED MEETS ALL STATUTORY REQUIREMENTS FOR RECORDING.

DATE 3-3-09 REVIEW OFFICER

THIS PLAT DOES NOT REQUIRE A CERTIFICATE OF APPROVAL BY THE DIVISION OF HIGHWAYS AS PROVIDED IN G.S. 136-102.6, SUB-


SIGNED [Signature] DATE 3-3-09
FOR PLANNING DIRECTOR

NOTES:

1. LINES BETWEEN PHASES HAVE NOT BEEN APPROVED AS PERMANENT PROPERTY LINES. D. STONE BUILDERS, INC. WILL DEVELOP AND CONVEY PROPERTY PHASE BY PHASE AT WHICH TIME SUCH PHASE WILL BE PLATTED AND RECORDED AS PART OF SEVEN GATES CONDOMINIUMS.

PHASING PLAN PREVIOUSLY RECORDED IN CPB. 13 PG 131

THE COMMON ELEMENTS HAVE BEEN CONVEYED TO, AND WILL BE MAINTAINED BY THE SEVEN GATES HOMEOWNERS ASSOCIATION AS RECORDED IN DEED BOOK 6567 PAGE 1447-1485.

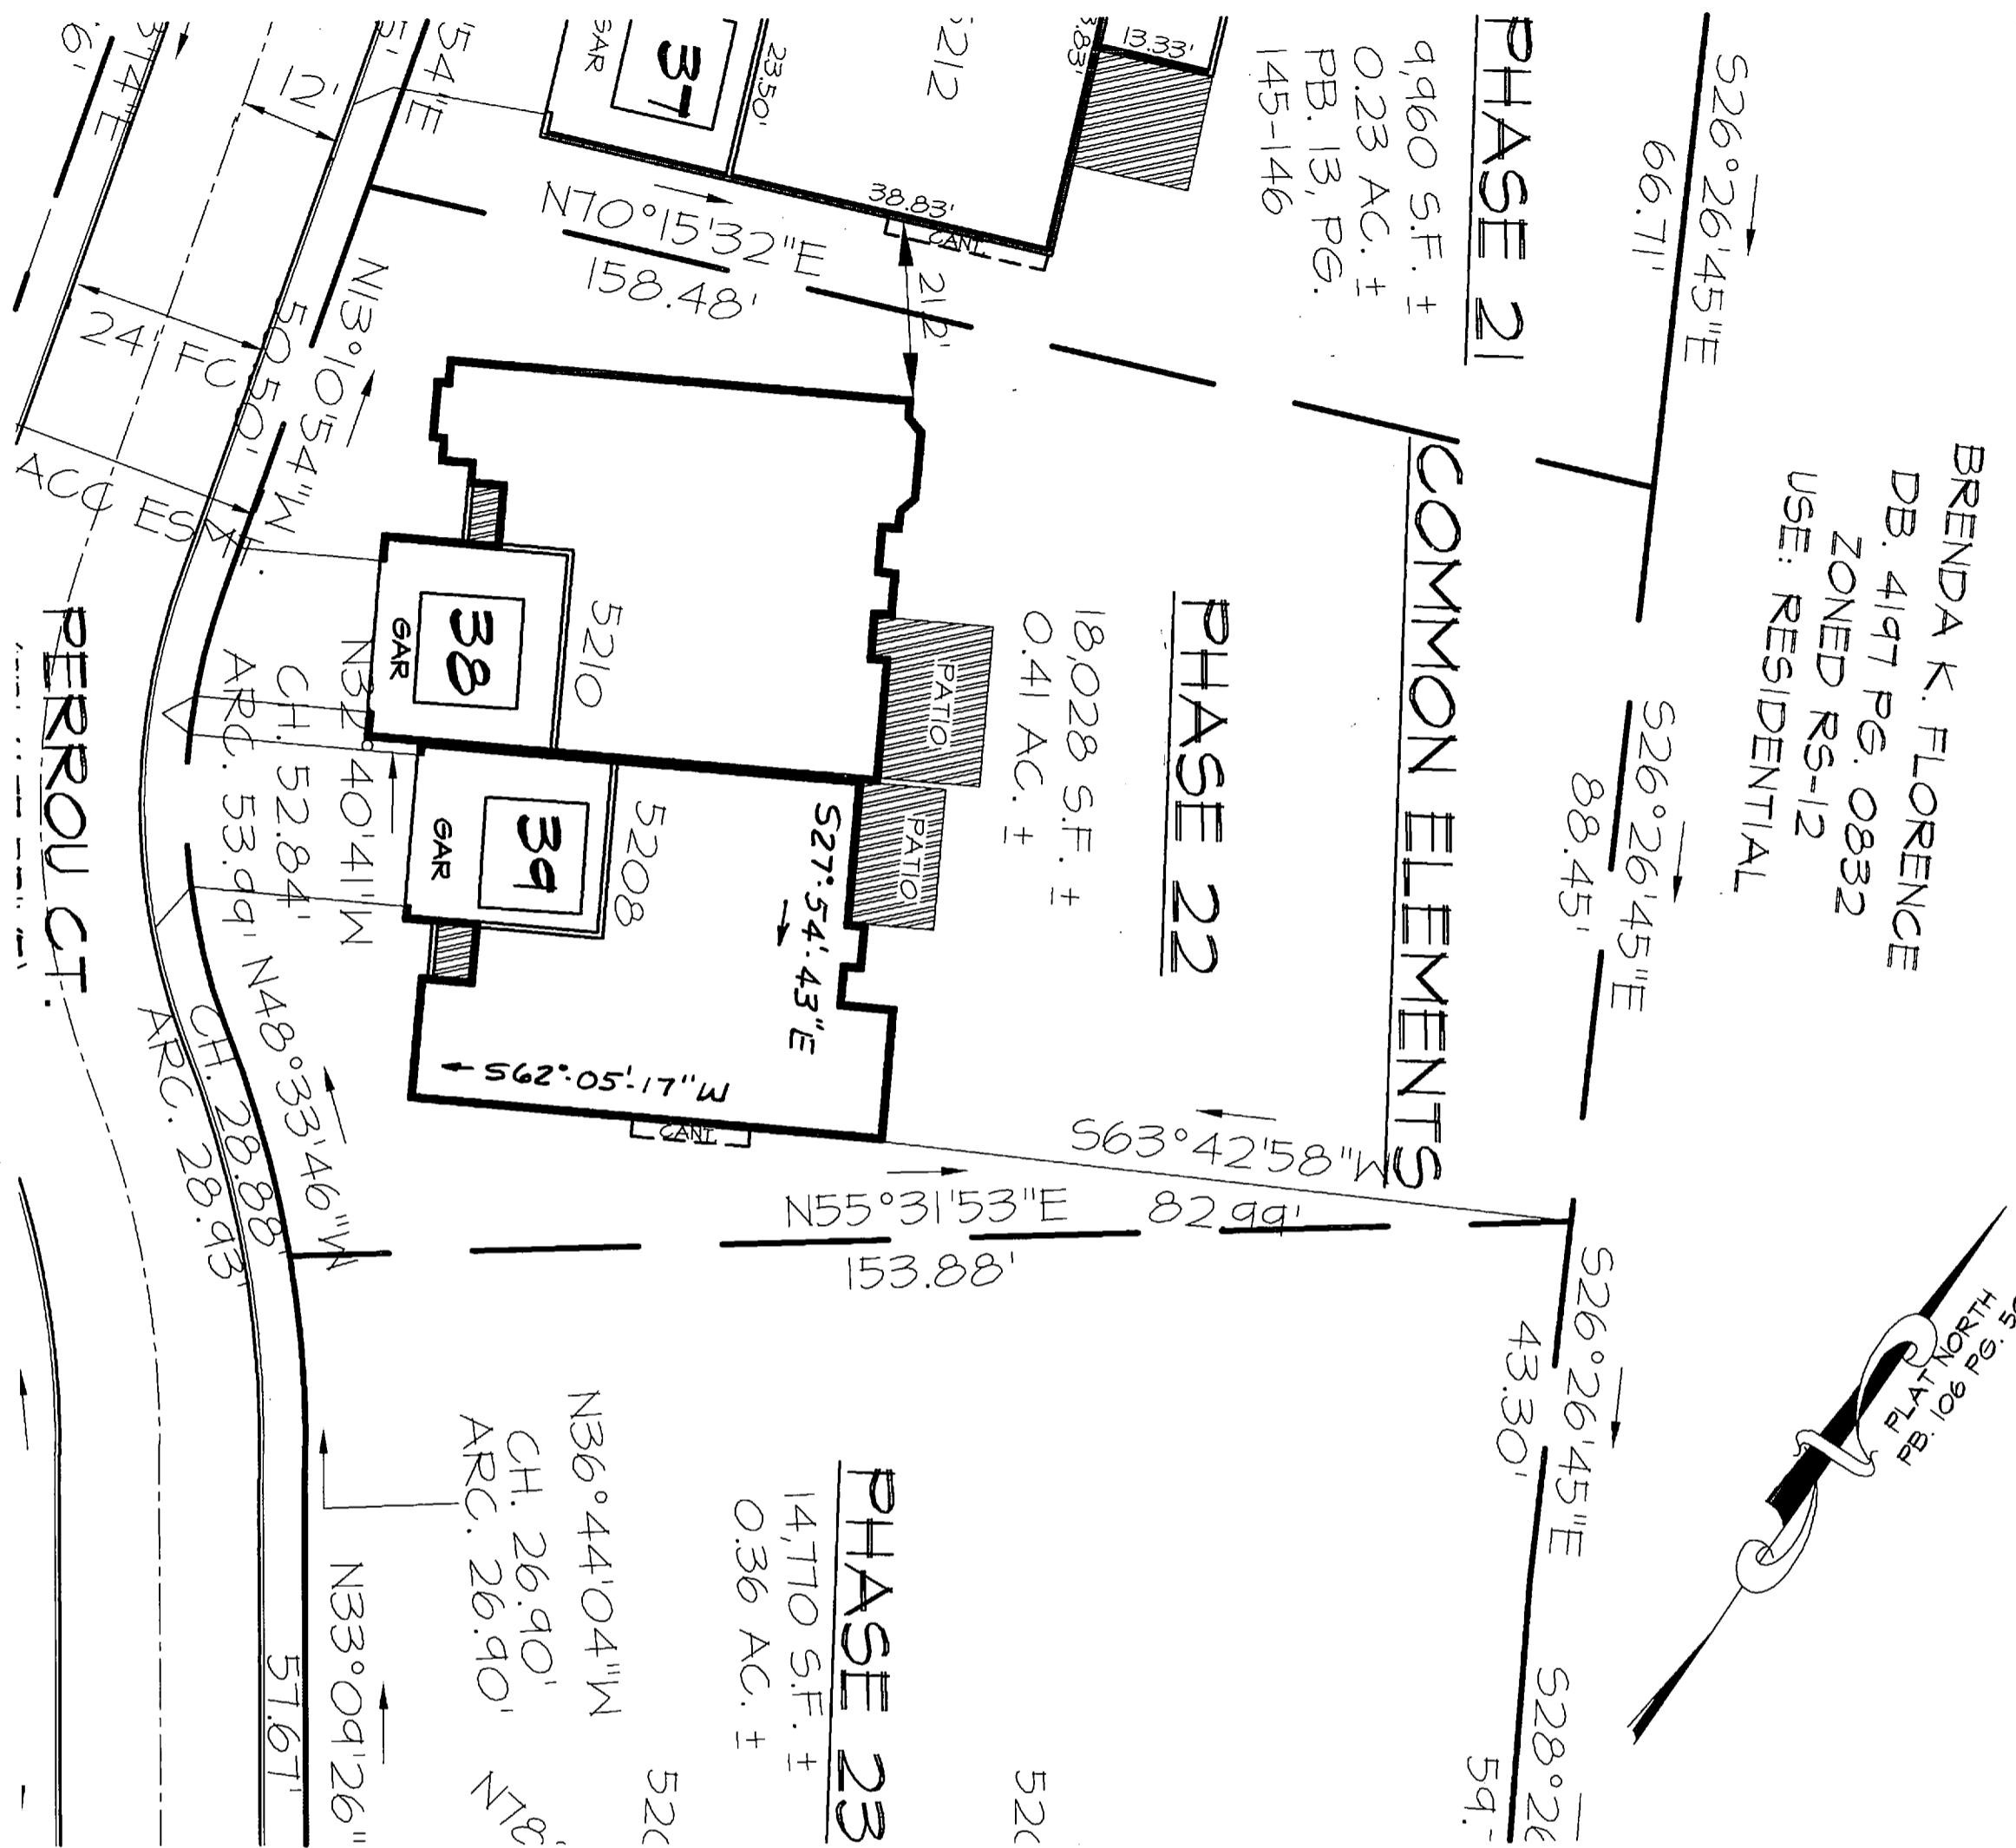

AND IMPROVEMENTS THEREON TO A PLAN OF CONDOMINIUM UNDER THE PROVISIONS OF CHAPTER 47C OF THE NORTH CAROLINA GENERAL STATUTES (NORTH CAROLINA CONDOMINIUM ACT). THE CONDOMINIUM SHALL BE KNOWN AS SEVEN GATES, PHASE 24, AND IS COMPOSED OF CONDOMINIUM UNITS, COMMON ELEMENTS AND FACILITIES (LIMITED COMMON ELEMENTS). ALL OF THE PROPERTY OTHER THAN THAT SHOWN ON SUCCEEDING SHEETS AS "CONDOMINIUM UNITS" OR "UNITS" IS COMMON ELEMENTS OR LIMITED COMMON ELEMENTS. LIMITED COMMON ELEMENTS ARE SHOWN AS HATCHED AREAS.


EACH CONDOMINIUM IS RESTRICTED TO RESIDENTIAL USE BY THE OWNER THEREOF, HIS IMMEDIATE FAMILY, GUESTS, INVITEES AND LESSEES IN ACCORDANCE WITH THE PROVISIONS OF THE DECLARATION OF CONDOMINIUM DATED 7-19-06, AND RECORDED IN DEED BOOK 6567 PAGE 1447-1485 OF THE GUILFORD COUNTY REGISTRY.

THE COMMON ELEMENTS AND LIMITED COMMON ELEMENTS EXPRESSLY ARE NOT DEDICATED HEREBY FOR USE BY THE GENERAL PUBLIC, BUT ARE OWNED IN COMMON BY ALL OF THE UNIT OWNERS IN THE CONDOMINIUM TO BE USED, AS THE CASE MAY BE, BY ALL OR A CERTAIN PORTION OF THE UNIT OWNERS, AS EXPRESSLY PROVIDED FOR IN THE DECLARATION. FURTHER, THE PRIVATE STREETS SHOWN ON THIS PLAT ARE A PART OF THE COMMON ELEMENTS AND EXPRESSLY ARE NOT DEDICATED TO USE BY THE GENERAL PUBLIC, BUT ARE FOR INGRESS, EGRESS AND REGRESS FOR OWNERS OF UNITS IN ALL PHASES OF SEVEN GATES.

D. STONE BUILDERS, INC., BY RECORDATION OF THE DECLARATION OF CONDOMINIUM AND THIS PLAT, HEREBY GIVES, GRANTS, AND CONVEYS TO BELLSOUTH TELECOMMUNICATIONS, DUKE ENERGY, PIEDMONT NATURAL GAS COMPANY INC., TIME-WARNER CABLE, AND THE CITY OF GREENSBORO, AND THEIR RESPECTIVE SUCCESSORS AND ASSIGNS, RIGHTS OF WAY AND EASEMENTS TO MAINTAIN AND SERVE THEIR RESPECTIVE LINES, WIRES, CONDUITS, AND PIPES IN THEIR PRESENT LOCATIONS WITHIN THE COMMON ELEMENTS AS SHOWN ON THIS PLAT, RECORDED IN THE GUILFORD COUNTY REGISTER OF DEEDS, AND THE SUCCEEDING SHEETS ATTACHED HERETO, TOGETHER WITH RIGHT OF INGRESS, EGRESS AND REGRESS OVER AND UPON SAID COMMON ELEMENTS FOR THE PURPOSE OF MAINTAINING AND SERVICING SAID LINES, WIRES, PIPES AND CONDUITS.

IN ADDITION D. STONE BUILDERS, INC. HEREBY GIVES TO SEVEN GATES THE RIGHT AND AUTHORITY TO GIVE, GRANT AND CONVEY TO BELLSOUTH TELECOMMUNICATIONS, DUKE ENERGY, PIEDMONT NATURAL GAS COMPANY INC., TIME-WARNER CABLE, THE CITY OF GREENSBORO, AND THEIR RESPECTIVE SUCCESSORS AND ASSIGNS, FURTHER RIGHTS OF WAY AND EASEMENTS THAT MAY BE NECESSARY TO CONNECT AND TO AND TO SERVICE THEIR RESPECTIVE LINES, WIRES, CONDUITS AND PIPES IN THEIR PRESENT LOCATIONS WITHIN THE COMMON ELEMENTS AS SHOWN HEREON, WITH THE LINES, WIRES, CONDUITS AND PIPES IN FUTURE PHASES (IF ANY) OF SEVEN GATES TOGETHER WITH THE RIGHT OF INGRESS, EGRESS AND REGRESS OVER AND UPON SAID COMMON ELEMENTS FOR SUCH PURPOSES.

I HEREBY CERTIFY THAT THESE PLATS AND PLANS CONTAIN ALL OF THE INFORMATION REQUIRED UNDER N.C. GENERAL STATUTES SECTION 47C-2-104 AND THAT THESE PLATS AND PLANS FULLY AND ACCURATELY DEPICT THE LAYOUT, CEILING AND FLOOR ELEVATIONS, UNIT NUMBERS AND DIMENSIONS OF THE UNITS, AS BUILT. I FURTHER CERTIFY THAT ALL STRUCTURAL COMPONENTS AND MECHANICAL SYSTEMS OF ALL BUILDINGS ARE SUBSTANTIALLY COMPLETED IN ACCORDANCE WITH THESE PLANS.

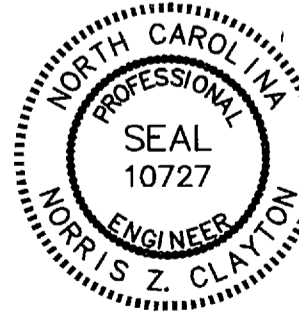

REGISTERED ENGINEER
REGISTRATION NUMBER #10121


FEBRUARY 6, 2009
DATE

LEGEND:

- CE = COMMON ELEMENTS
- EIP = EXIST. IRON PIPE
- NIP = NEW IRON PIPE
- CH = CHORD DISTANCE
- CPB = CONDOMINIUM PLAT BOOK
- FB = FLAT BOOK
- DB = DEED BOOK
- PS = PAGE
- [] = UNIT LABELS
- [] = LIMITED COMMON ELEMENTS


SETBACKS:
FRONT: 20'
SIDE: 15'
REAR: 50'

OWNERS:
D. STONE BUILDERS, INC.
2904 LANWDALE DRIVE
GREENSBORO, NC 27429
PHONE (336) 288-4393

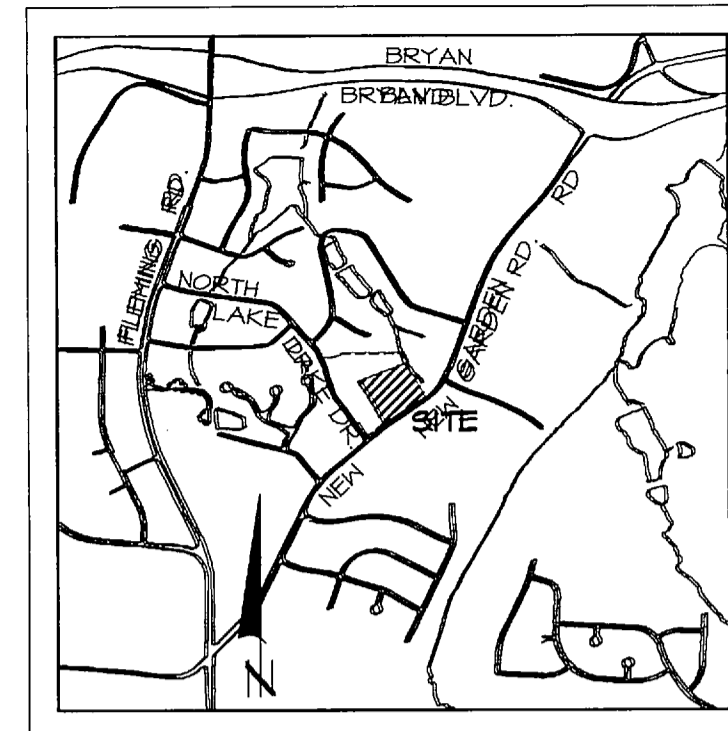

VICINITY MAP ~ 1" = 2,000'

ALL DIMENSIONS ARE EXTERIOR DIMENSIONS

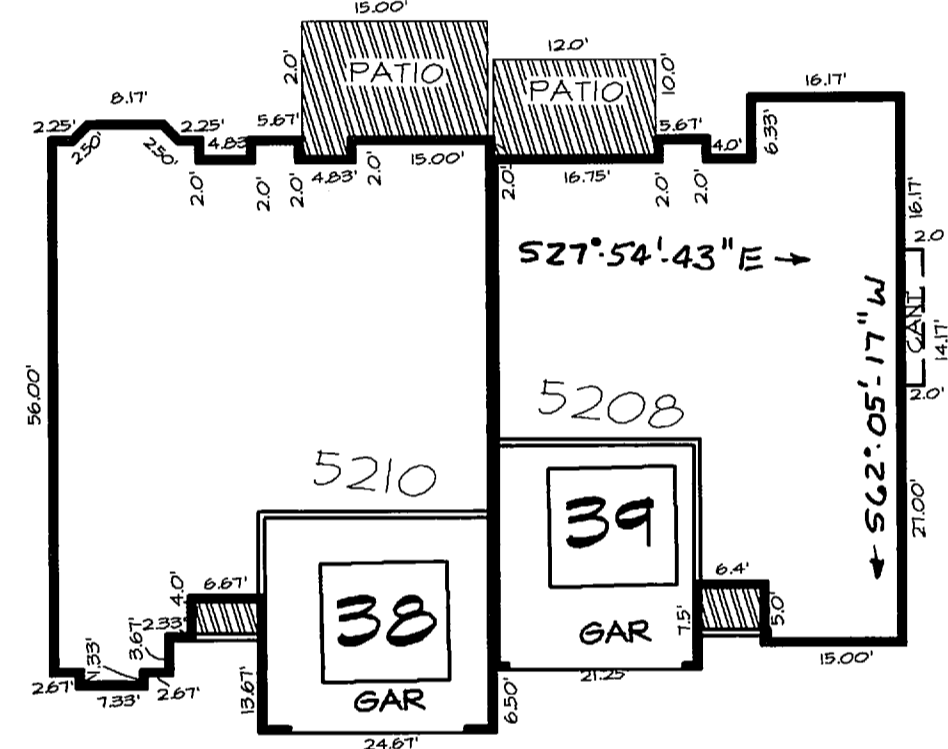

2009017416
GUILFORD CO, NC FEE \$42.00
PRESENTED & RECORDED
03-26-2009 09:02:03 AM
JEFF L. THIGPEN
REGISTER OF DEEDS
BY: LINDA F. ALLRED
DEPUTY-GB

BK: C 14
PG: 38-39

FINAL PLAT SEVEN GATES A CONDOMINIUM PHASE 22 SHEET 1 OF 2

D. STONE BUILDERS, INC.

5210 & 5208 PERROU CT.

MOREHEAD TOWNSHIP, GUILFORD COUNTY
GREENSBORO, NORTH CAROLINA

SCALE: 1"=20' DATE: FEBRUARY 6, 2009

0 10' 20' 40'


HUGH CREED ASSOCIATES, INC., P.A.
CONSULTING ENGINEERS & LAND SURVEYORS

P.O. BOX 9623
1306 W. WENDOVER AVE.
GREENSBORO, N.C. 27408

PHONE: (336) 275-9826
OR (336) 275-8084
FAX: (336) 275-3379

B-1647-A

Now J. C. [Signature]
PROFESSIONAL ENGINEER
REGISTRATION NUMBER #10727
FEBRUARY 6, 2009
DATE

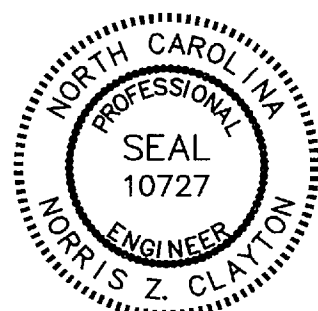

D. STONE BUILDERS INC

SIGNED [Signature]
PRESIDENT

ATTEST [Signature]
SECRETARY



E LEGAL
 S OF
 IFY
 OF

16.09'
 16.09'
 3.29'
 2nd F.F.E. = 882.64
 2nd F.C.E. = 890.78

11.26'
 9.94'
 5.15'
 BATH
 2.35'
 3.15'
 1.98'
 3.91'
 4.30'
 W.I.C.
 10.37'
 7.55'
 16.55'
 2.15'
 .50'
 14.23'
 6.08'
 14.33'
 14.23'
 2nd F.F.E. = 882.64
 2nd F.C.E. = 890.78
 BDRM 3

1"=10'

C/L TENANT SEPARATION WALL

O.S.B. SHEATHING

2X8 RAFTERS @ 16" O.C.

LIMIT OF OWNERSHIP

SUB FLOOR
FACE OF SHEET ROCK
(CEILINGS & WALLS)
TOP OF CONCRETE
FLOOR IN GARAGE

1 LAYER OF 1/2" DRYWALL

4" BLOCK WALL

2X10 FLOOR JOIST @ 16" O.C.

12" BLOCK WALL

LIMIT OF OWNERSHIP

SUB FLOOR
FACE OF SHEET ROCK
(CEILINGS & WALLS)
TOP OF CONCRETE
FLOOR IN GARAGE

1 LAYER OF 1/2" DRYWALL

2X10 FLOOR JOIST @ 16" O.C.

TENANT SEPARATION WALL DETAIL

NO SCALE



SECOND FLOOR

2XB RAFTERS

FIRST FLOOR

2X10 JOIST
1/2" GYPSUM BOARD (SHEETROCK)

LIMIT OF OWNERSHIP
SUB FLOOR
FACE OF SHEET ROCK (CEILINGS & WALLS)
TOP OF CONCRETE FLOOR IN GARAGE

SHEATHING

BRICK VENEER

FLOOR COVERING
SUB FLOOR



CRAWL SPACE

2X10 JOIST

4" BLOCK

CONTINUOUS CONC. FOOTING 16"X10"

8'-0"
7'-6"
1'-0"
1'-0"

LEGEND:
F.F.E. = FINISHED FLOOR ELEVATION
F.C.E. = FINISHED CEILING ELEVATION
 = UNIT LABELS
 = LIMITED COMMON ELEMENTS

PHONE: (336) 275-9826
OR (336) 275-8084
FAX: (336) 275-3379